


E1 E2 E3 E4 E5 E6 E7 E8 E9 E10

+104.500
PLAN
+101.200
PLAN
+97.900
PLAN
+94.300
PLAN



BIBLIOTEK
FASAD MOT ?STER


E10 E11 E12 E13 E14

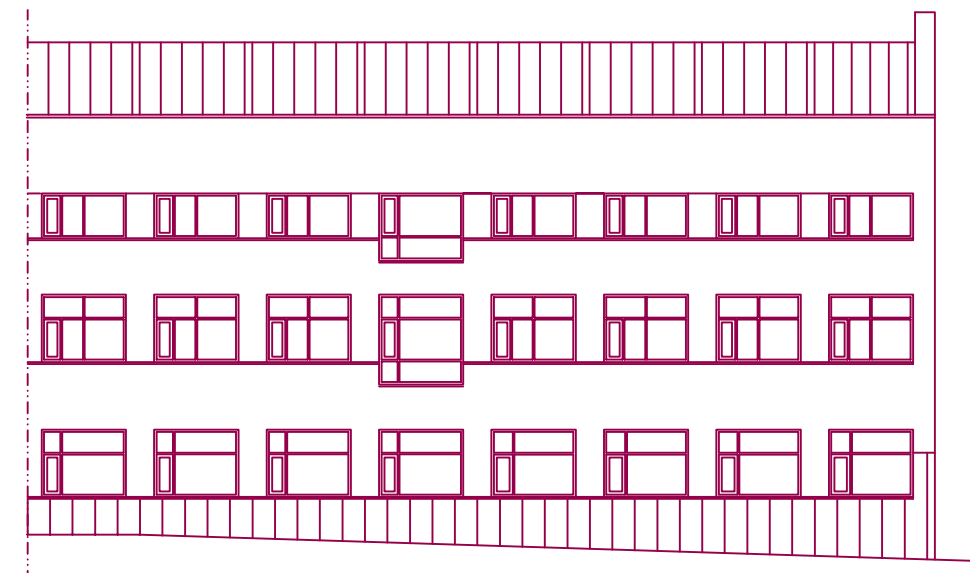

BIBLIOTEK
FASAD MOT ?STER



RES	ANT	REGISTERINGEN	AVSER	SIGN	DATUM

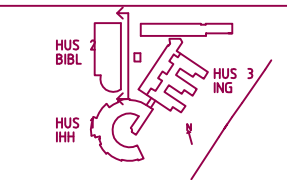

white
arkitekter
White arkitekter AB Magnusgatan 10 Box 2802,
403 17 Göteborg Tel 031 40 08 00 Fax 031 40 08 10
ANSVARS
7KE JOHANSSON
DATUM
2004-03-31

SKANSKA
ANSVARS

RELATIONSHANDLING
KV JMV 4
H?GSKOLAN I J?NK?PING
HUS 2 BIBLIOTEK
FASAD MOT ?STER
UPPDRAGSNUMMER
RITNINGNUMMER
REV.
A30:291