
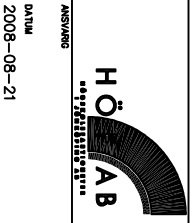
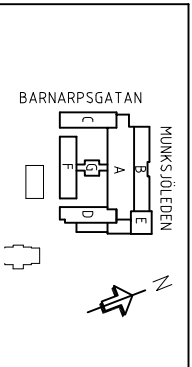
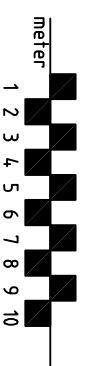


RELATIONSHANDLING	
PLAN 04, HUS 05	
A	2008-01-31
K	
E	
V	

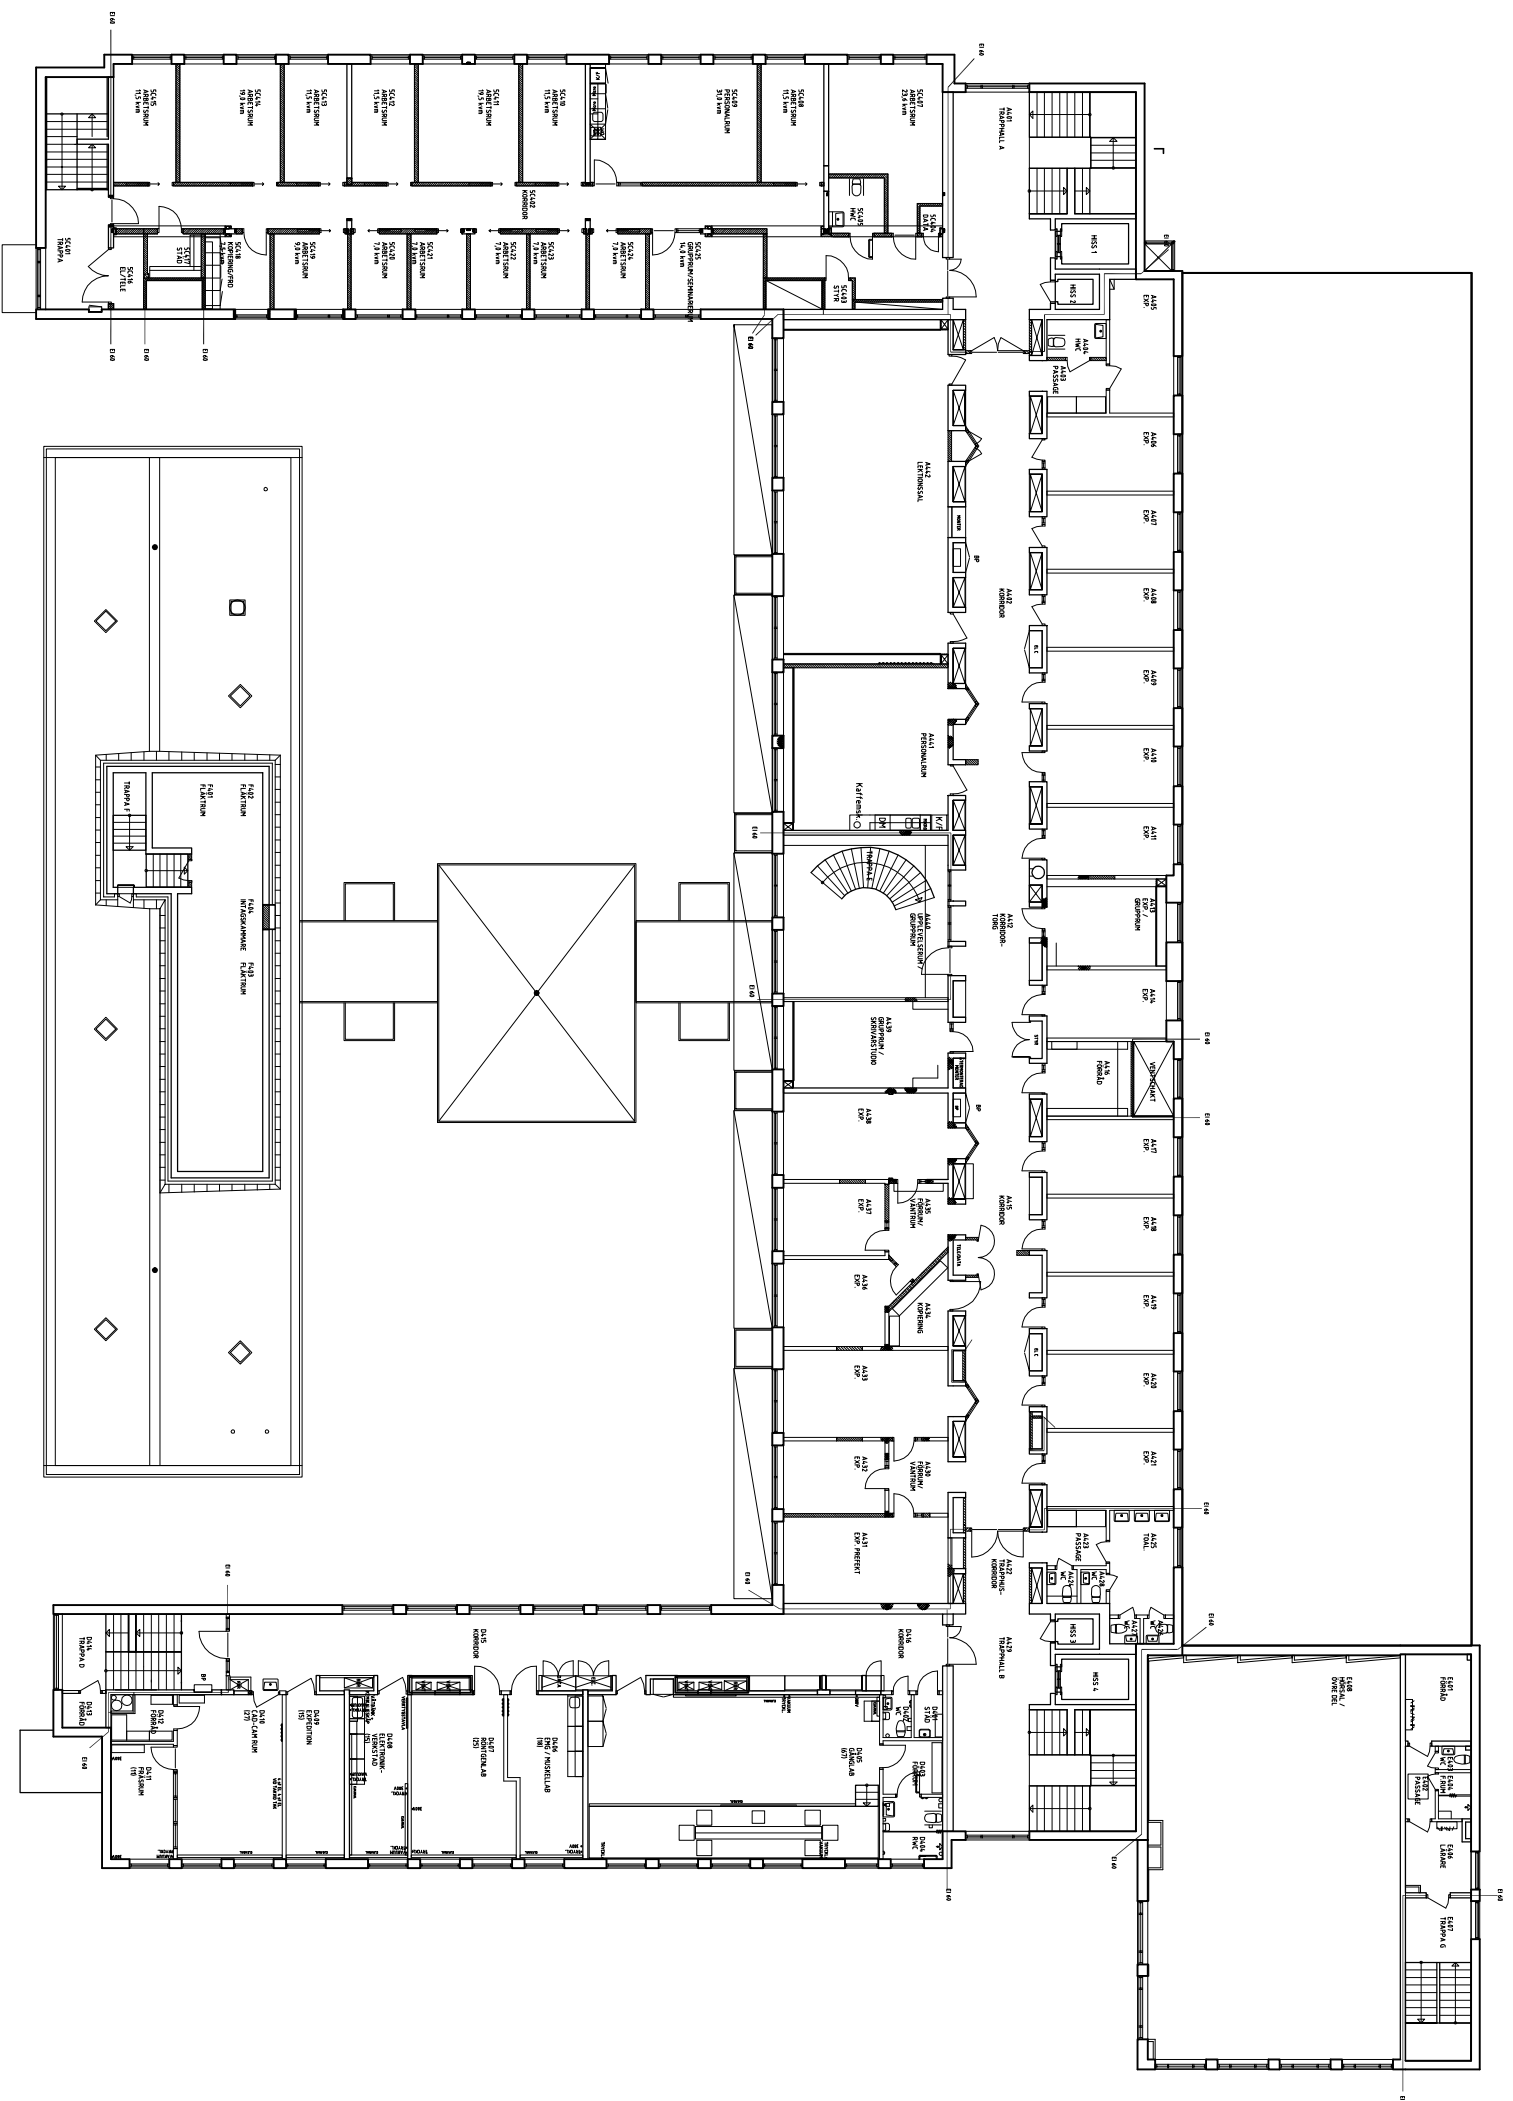

HÖGSKOLAN i JÖNKÖPING
HUS 5 HÄLSÖHÖGSKOLAN
PLAN 4

ANSVARIG
DATUM
2008-08-21

SKALA
1: 300

RISSNUMMER
Aplan04h05.dwg

REV.