
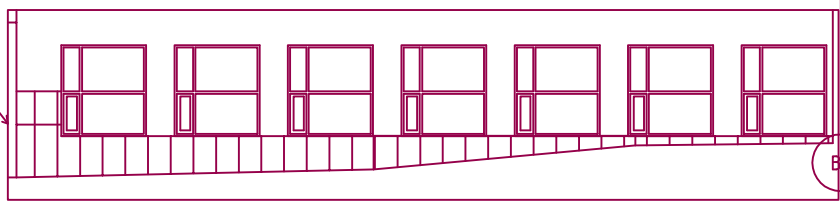


A270 A255 A240 A225 A210 B0 B1 B2 B3 B4 B5 B6 R360

+116.800  
PLAN 7  
+113.200  
PLAN 6  
+109.600  
PLAN 5  
+106.000  
PLAN 4  
+102.400  
PLAN 3  
+98.800  
PLAN 2  
+94.300  
PLAN 1  
+91.000  
PLAN 0


HANDELSHÖGSKOLAN  
FASAD MOT ÖSTER

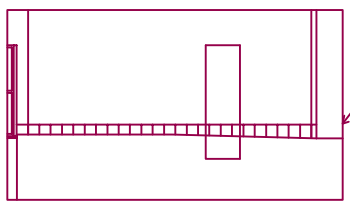

B4 B4.1 B5.1 B6

RELATIONSHANDLING

REG	ANT	REGISTRERINGEN	AVSER	SIGN	DATUM

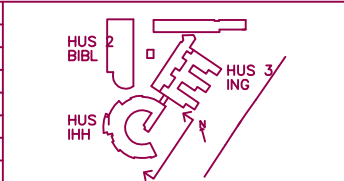

**white arkitekter**  
White arkitekter AB Magnusregatan 10 Box 5802,  
403 17 Göteborg Tel 031-80 86 00 Fax 031-80 86 10  
ANSVARIG  
PÅKE JOHANSSON  
DATUM  
2005-01-15

**SKANSKA**  
ANSVARIG

KV JM V 4  
HÖGSKOLAN i JÖNKÖPING  
HUS 1 IHH  
FASAD MOT ÖSTER  
UPPDRAGSNUMMER  
RITNINGNUMMER  
A30:194  
REV.