


C0 C1 C2 C3 C4 C5 C6 C7 C8 C9



INGENJ?RSH?GSKOLAN
S?DRA SK?NKELN MOT S?DER


C9 C8 C7 C6 C5 C4 C3 C2 C1 C0

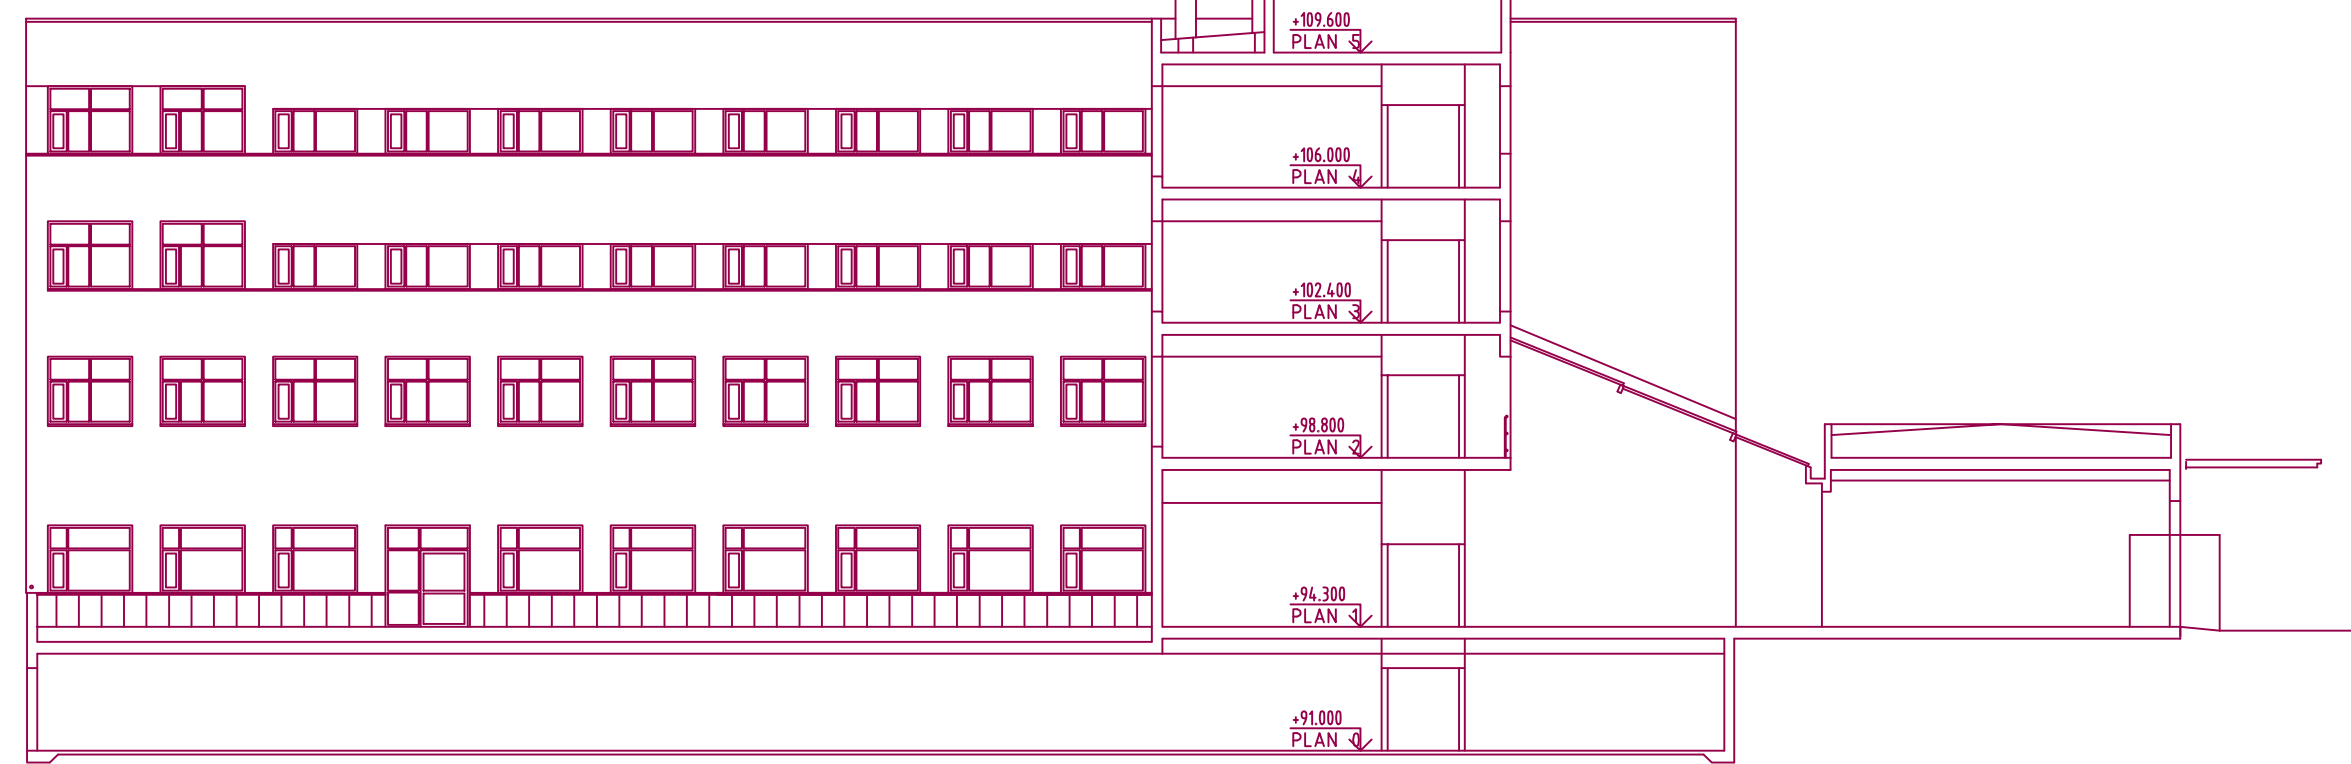

INGENJ?RSH?GSKOLAN
S?DRA SK?NKELN MOT NORR



REG	ANT	REGISTRERINGS	AVSER	SIGN	DATUM

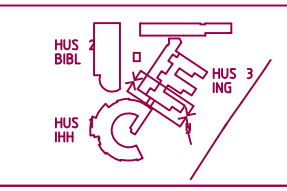

white arkitekter
 White arkitekter AB Magnuslegatan 10 Box 2602,
 403 17 Göteborg Tel 031-60 88 00 Fax 031-60 88 10

ANSVARIG
 TKE JOHANSSON
 DATUM
 2004-03-31

SKANSKA

ANSVARIG

RELATIONSHANDLING

KV JMV 4
 H?GSKOLAN i J?NK?PING
 HUS 3 INGENJ?RSH?GSKOLAN
 FASADER S?DRA SK?NKELN

UPPRAGSNUMMER
 RITNINGSNUMMER
 A30:393

REV.