



INGENJ?RSH?GSKOLAN
FASAD MOT ?STER



F?RBINDELSEG?NG
FASAD MOT ?STER

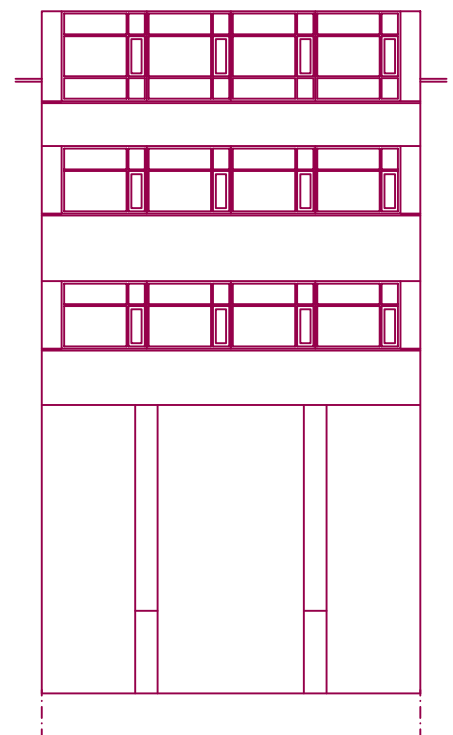

RES	AMT	REGISTRERINGEN AVSER	SEK	DATUM

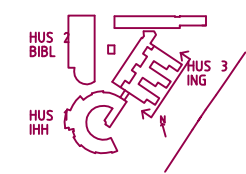

white
arkitekter

White arkitekter AB Magnusgatan 10 Box 2002
403 17 Göteborg Tel 031-80 96 00 Fax 031-80 96 10

ANSVARE
?KE JOHANSSON
DATUM
2004-03-31

RELATIONSHANDLING

SKANSKA

KV JMV 4
H?GSKOLAN i J?NK?PING
HUS 3 INGENJ?RSH?GSKOLAN
FASAD MOT ?STER

UPPRAGSNUMMER	RITNINGNUMMER	REV.
	A30:392	