
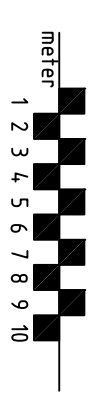


RELATIONSHANDLING	
HUS 9, PLAN 2	
A/K	2006-05-19
E	
V	

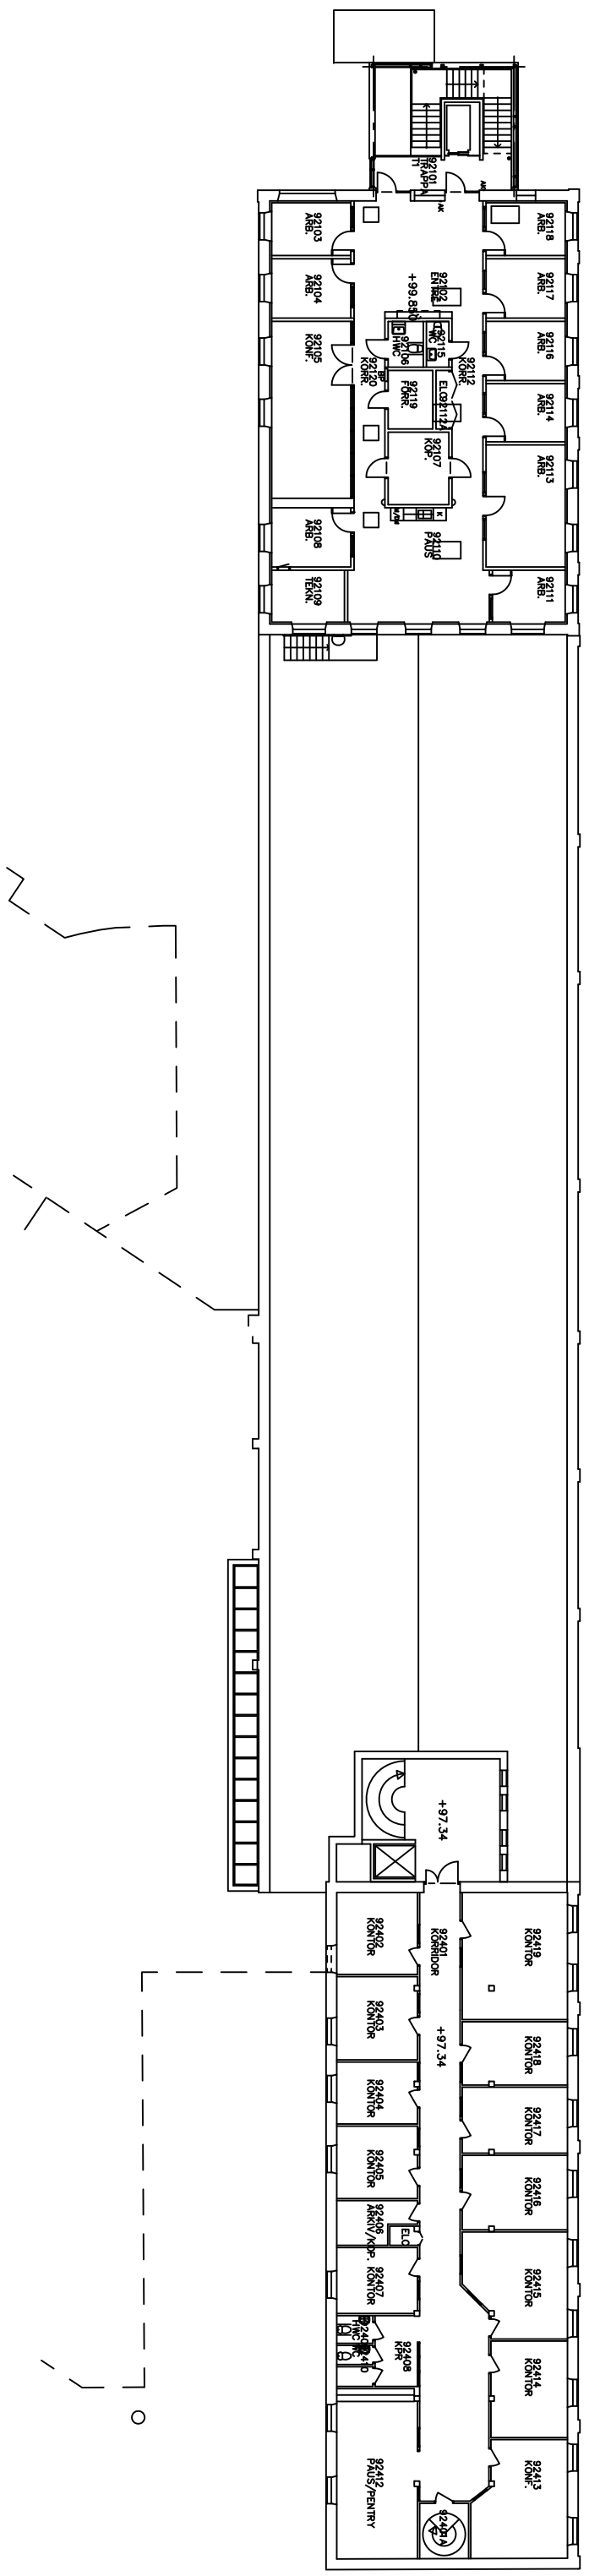

		HÖGSKOLAN i JÖNKÖPING HUS 9 Studentermaskus PLAN 2
		SKALA 1:300
ANSVARIG Stefan Bodin Datum 2007-03-30		REV.