
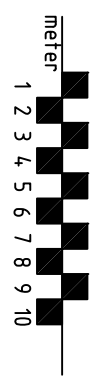


RELATIONSHANDLING	
HUS 9, PLAN 3	
A/K	2007-09-05
E	
V	

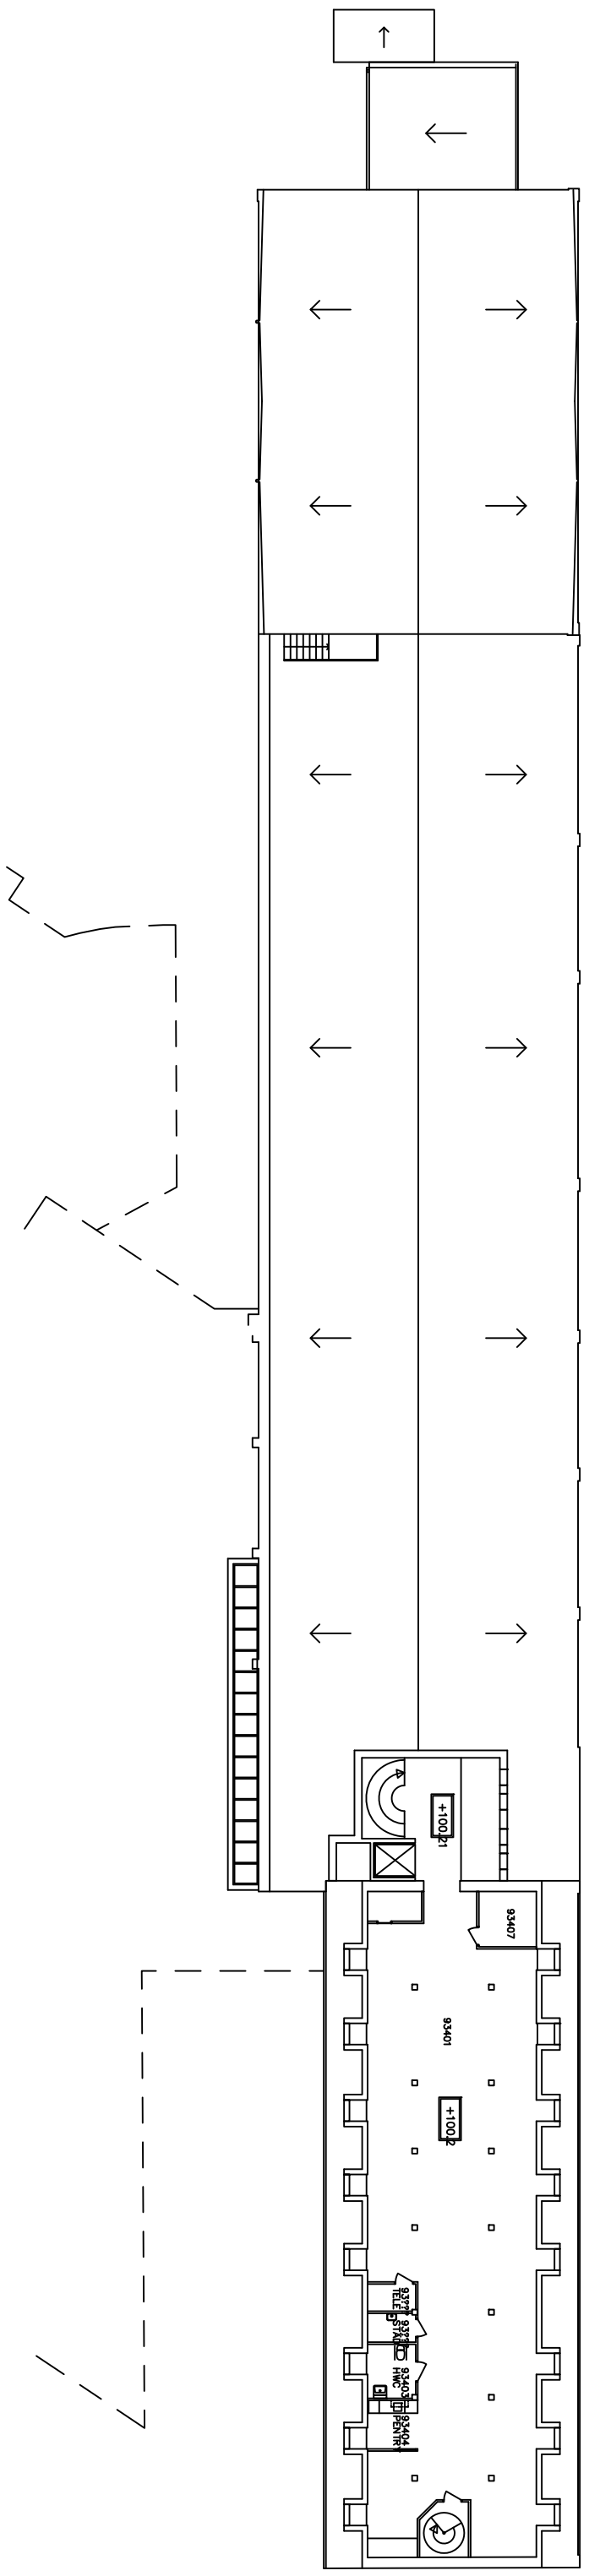

		<p>HÖGSKOLAN i JÖNKÖPING HUS 9 Studentermaskus PLAN 3</p>
<p>ANSVARIG Stefan Bodin Skala 2007-03-30</p>	<p>SKALA 1:300</p>	<p>RITNINGNUMMER Aplan3h9</p>