
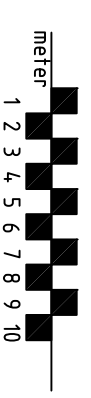


RELATIONSHANDLING	
HUS 9, TAKPLAN	
A/K	2006-05-19
E	
V	

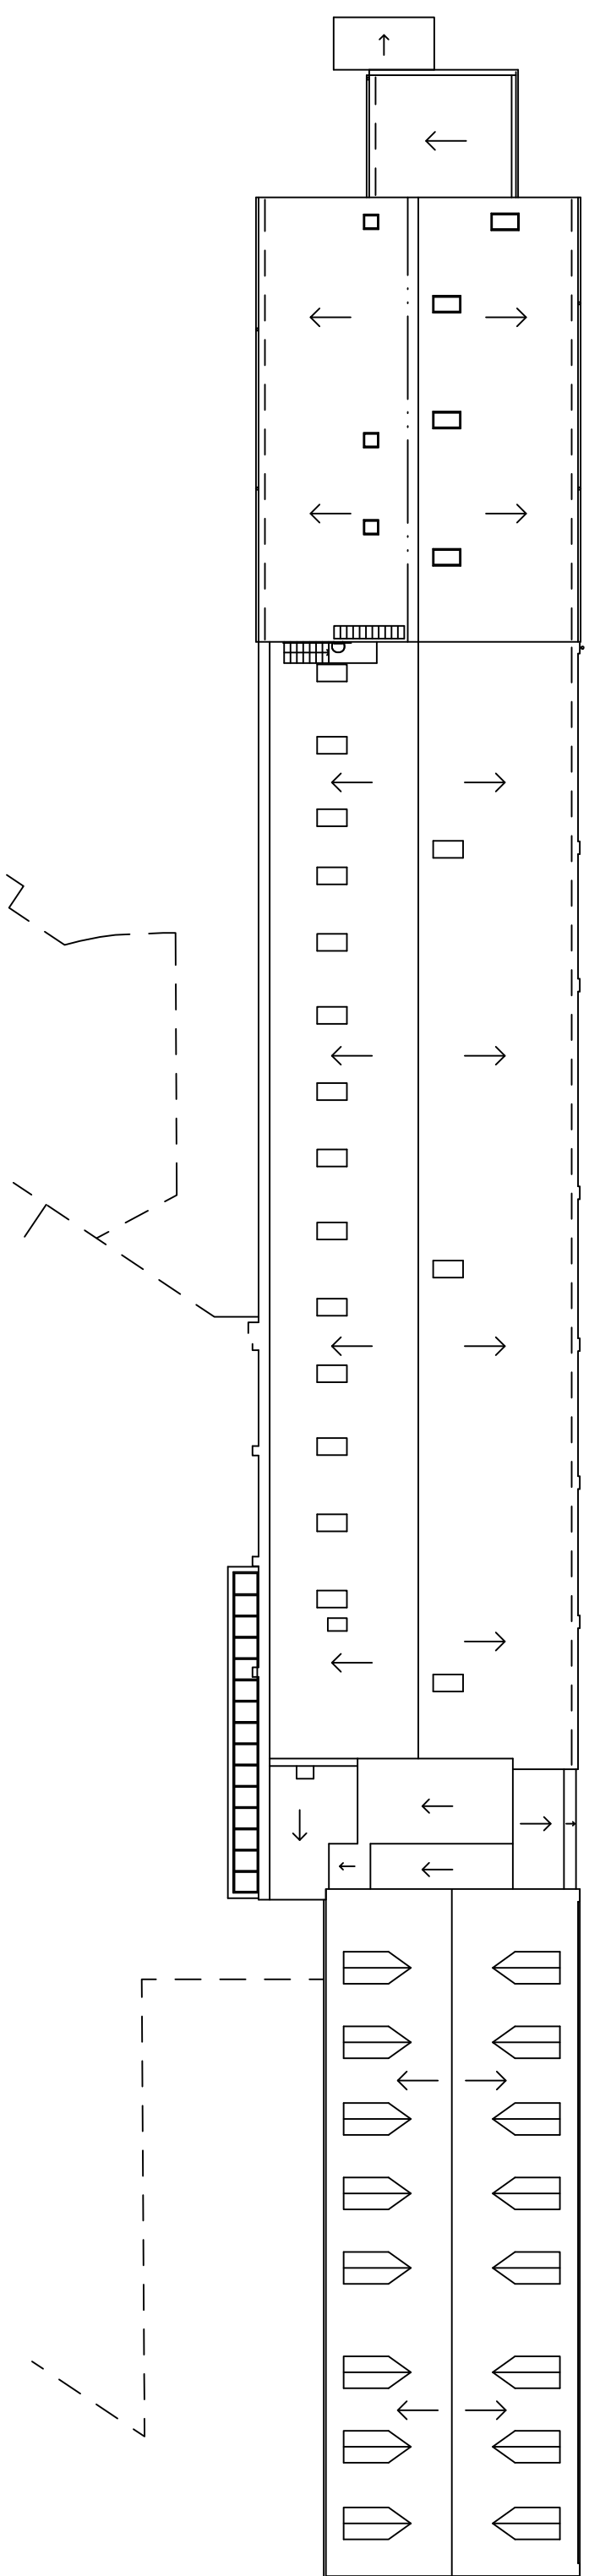

		ANSVARIG Stefan Bodin Skala 2007-03-30	HÖGSKOLAN i JÖNKÖPING HUS 9 Studentermashys PLAN 4	SKALA 1:300	RITNINGSNUMMER Aplän4h9	REV.
		HUS 1 HUS 2 HUS 3 HUS 4 HUS 9				